

LEGEND


- EXTG EXISTING
- GS GARDEN SHED
- MSB MAIN SWITCH BOARD
- OT HEATING OIL TANK
- SB SOLAR BOARD
- SP WATER STANDPIPE
- TP TELEPHONE LINE PIT
- TYP TYPICAL

LEGEND: UNDERGROUND SERVICES

- E ELECTRICITY
- D RAIN WATER
- O HEATING OIL
- P SEPTIC PUMP OUT (OBSLETE)
- R SOLAR ELECTRICITY
- S SEWER PLUMBING
- T TELEPHONE
- W WATER PLUMBING

SITE AREAS

GROUND FLOOR AREA	118 m ²
PATIOS	27 m ²
OUT BUILDINGS	66 m ²
OPEN AREA	806 m ²
TOTAL AREA	1017 m²

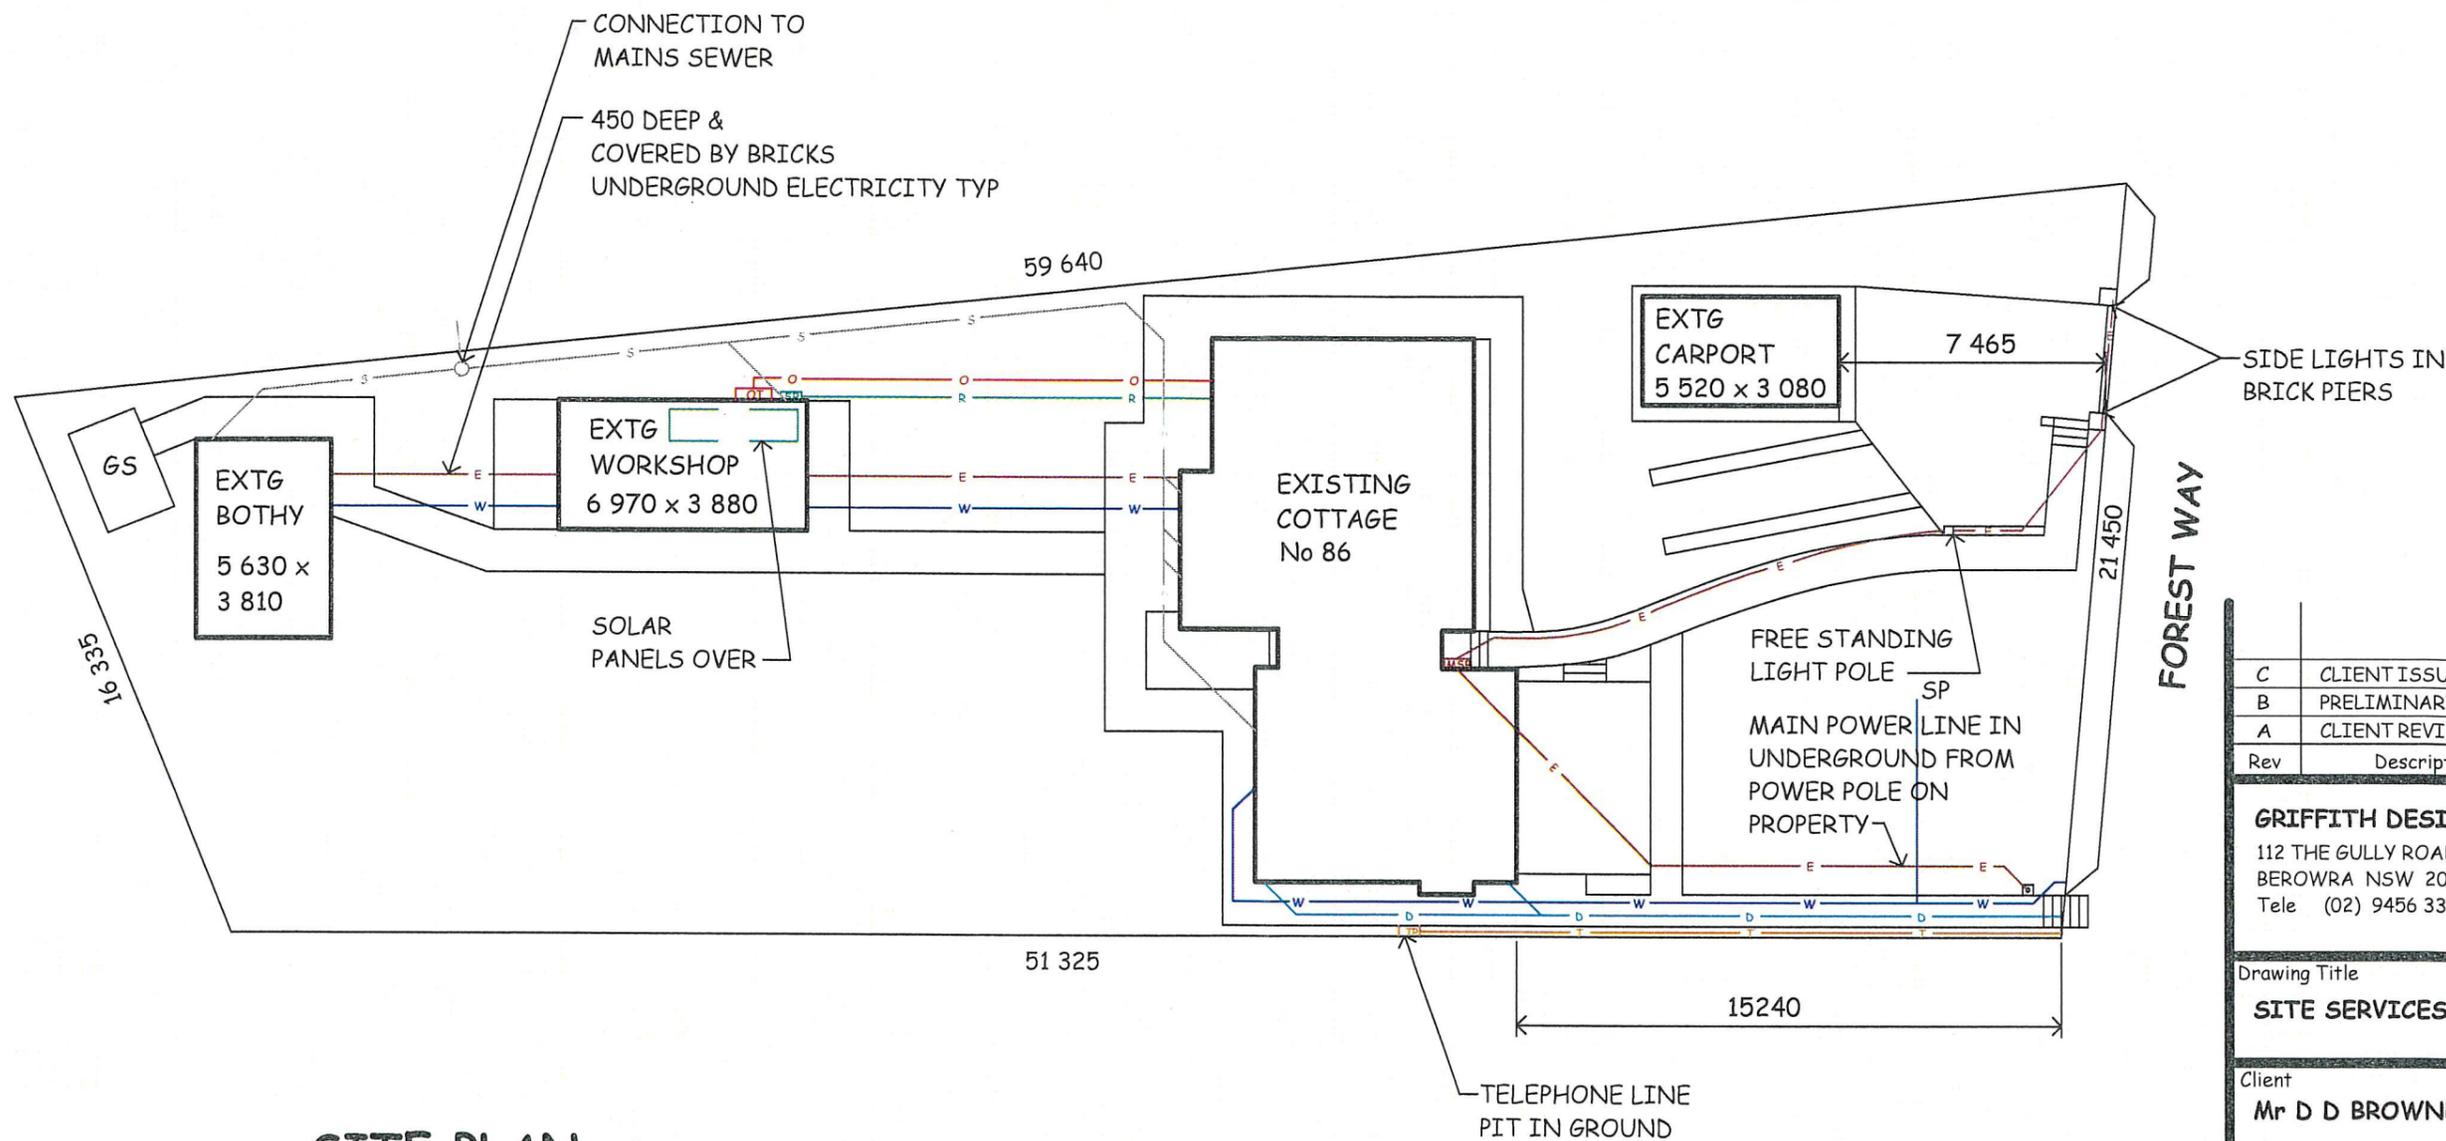

SITE PLAN

SCALE 1:200



NOTE:
PREVIOUS ADDRESS OF RESIDENCE
LOT 38 PYMBLE ROAD
SORLIE

Rev	Description	Date
C	CLIENT ISSUE	21/01
B	PRELIMINARY ISSUE	04/01
A	CLIENT REVIEW	14/12

GRIFFITH DESIGNS

112 THE GULLY ROAD
BEROWRA NSW 2081
Tele (02) 9456 3330

Drawing Title
SITE SERVICES PLAN

Client
Mr D D BROWNE

Project Description
**AS BUILT
RESIDENCE
58 Forest Way
FRENCHS FOREST 2086**

Drawn	IG	Number in set	-
Date	14 DEC 15	Project Number	
Checked		2586	1C
Scale	1:200		